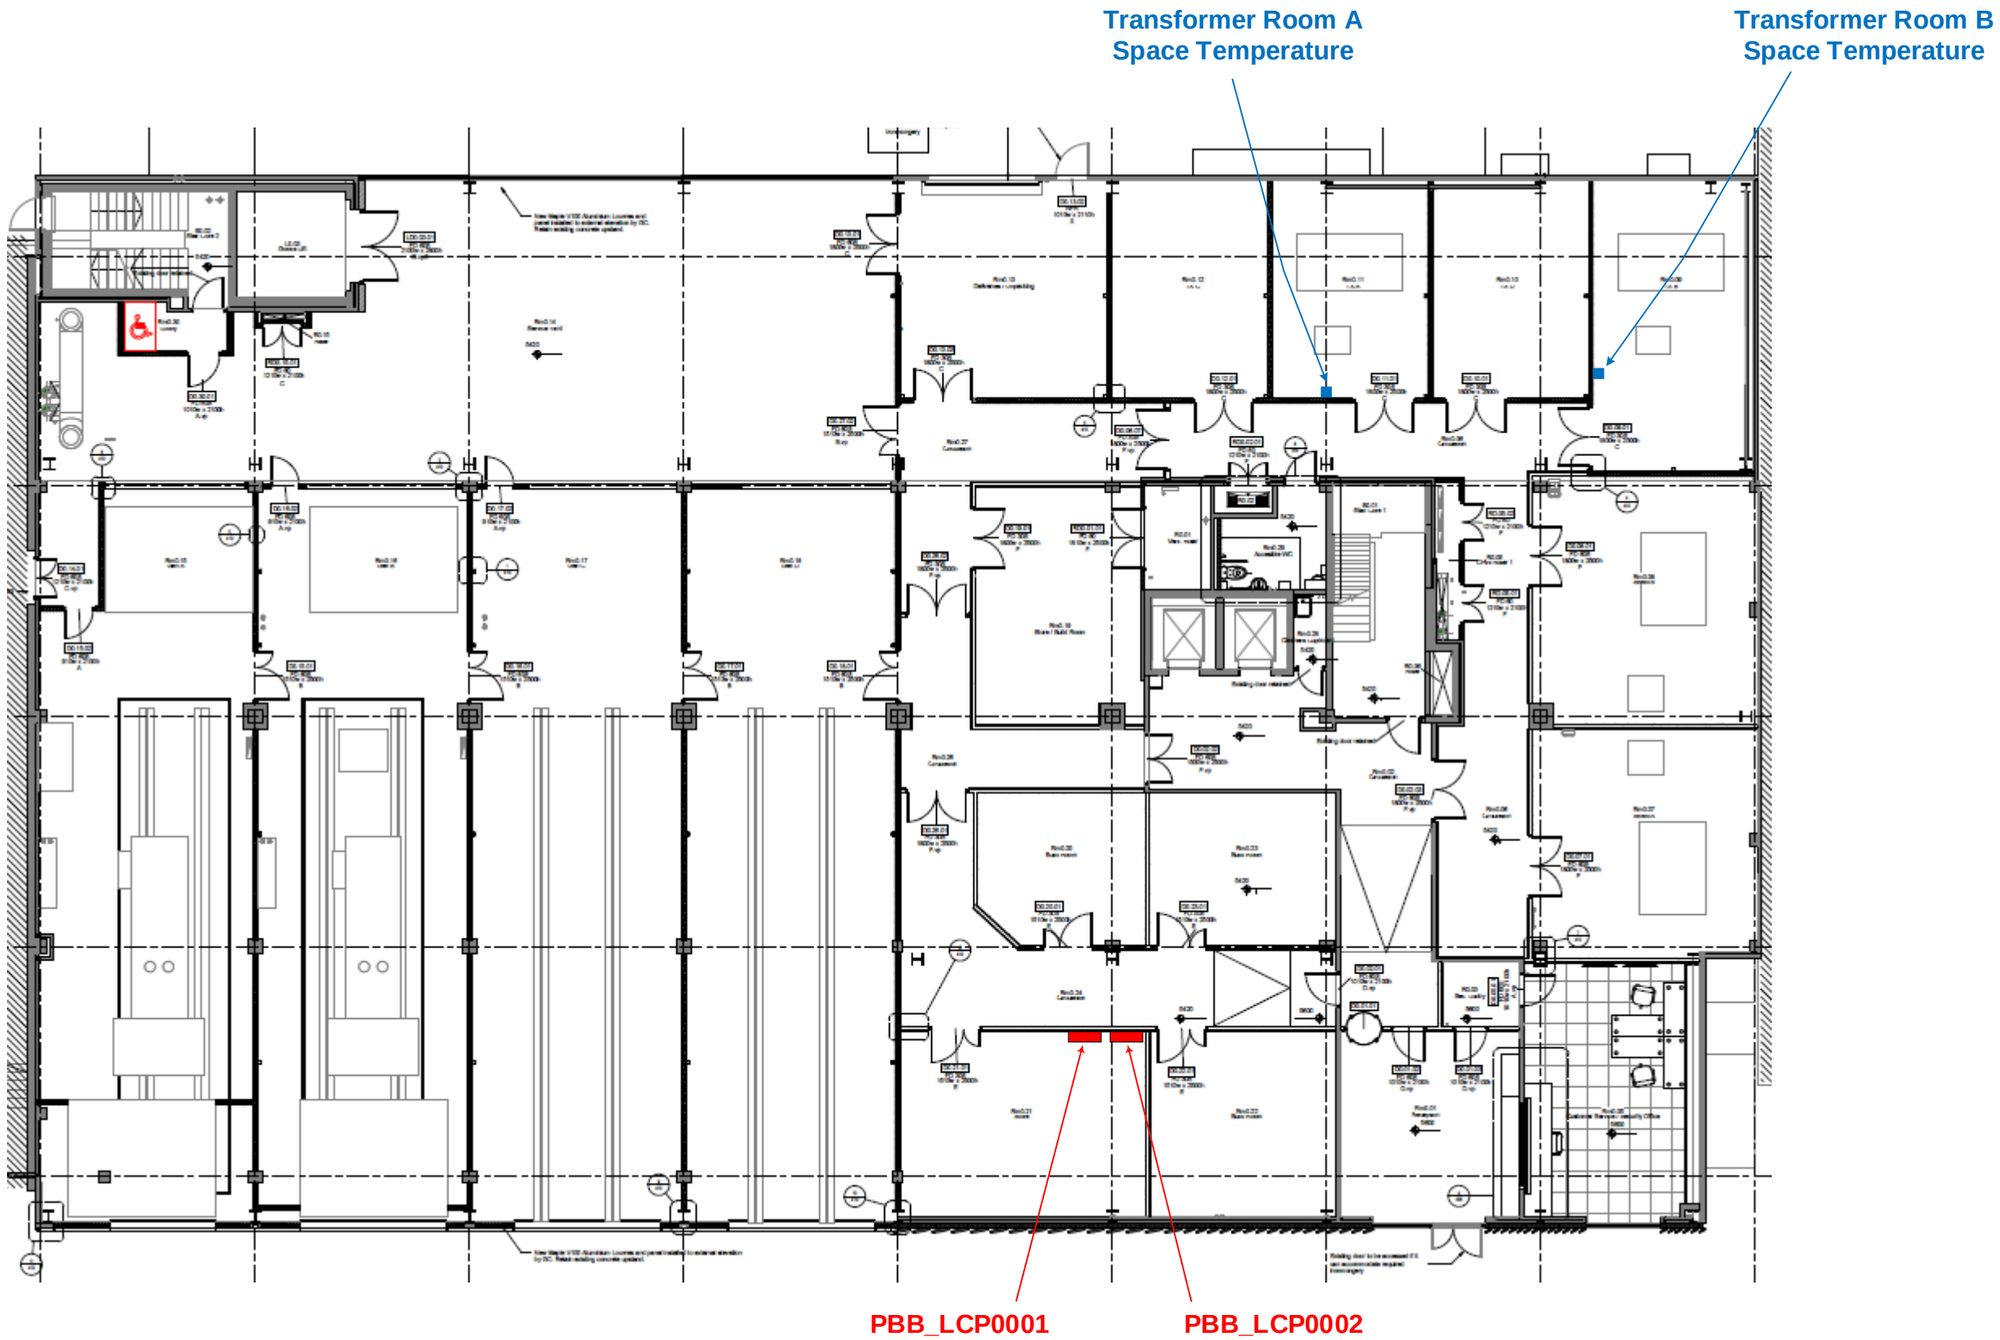

Project	Title	Project Number	Client	Rev	Description	Date	Drawn	Checked
LHR19	Ground Floor BMS Equipment Locations	T1.00869	Digital Realty	P1	First Issue	20/06/19	NL	NL
				C1	Panel Locations Amended	11/07/19	NL	NL
				AB1	As Installed	05/11/19	NL	NL
		Sheet Name: Level GF	Contractor: Gratte Brothers	AB2	Future Points Removed	13/11/19	NL	NL
				.	.	.	.	.
				.	.	.	.	.
				.	.	.	.	.

Notes
1 - All IT infrastructure by others
2 - All power supplies by others
3 - CAT 5e cable
4 - RS485 Belden 9182 or equivalent

Schneider Electric

Page Size: A3

Design Stage	
Concept Design	
Developed Design	
Technical Design	✓
Information Only	

Sheet	Drawing Number	Rev
1 of 1	GB7102-SCN-E-DR-GF-0002	AB2

These drawings and designs are the property of Schneider Electric. Their use or reproduction without prior consent of the company is strictly forbidden.