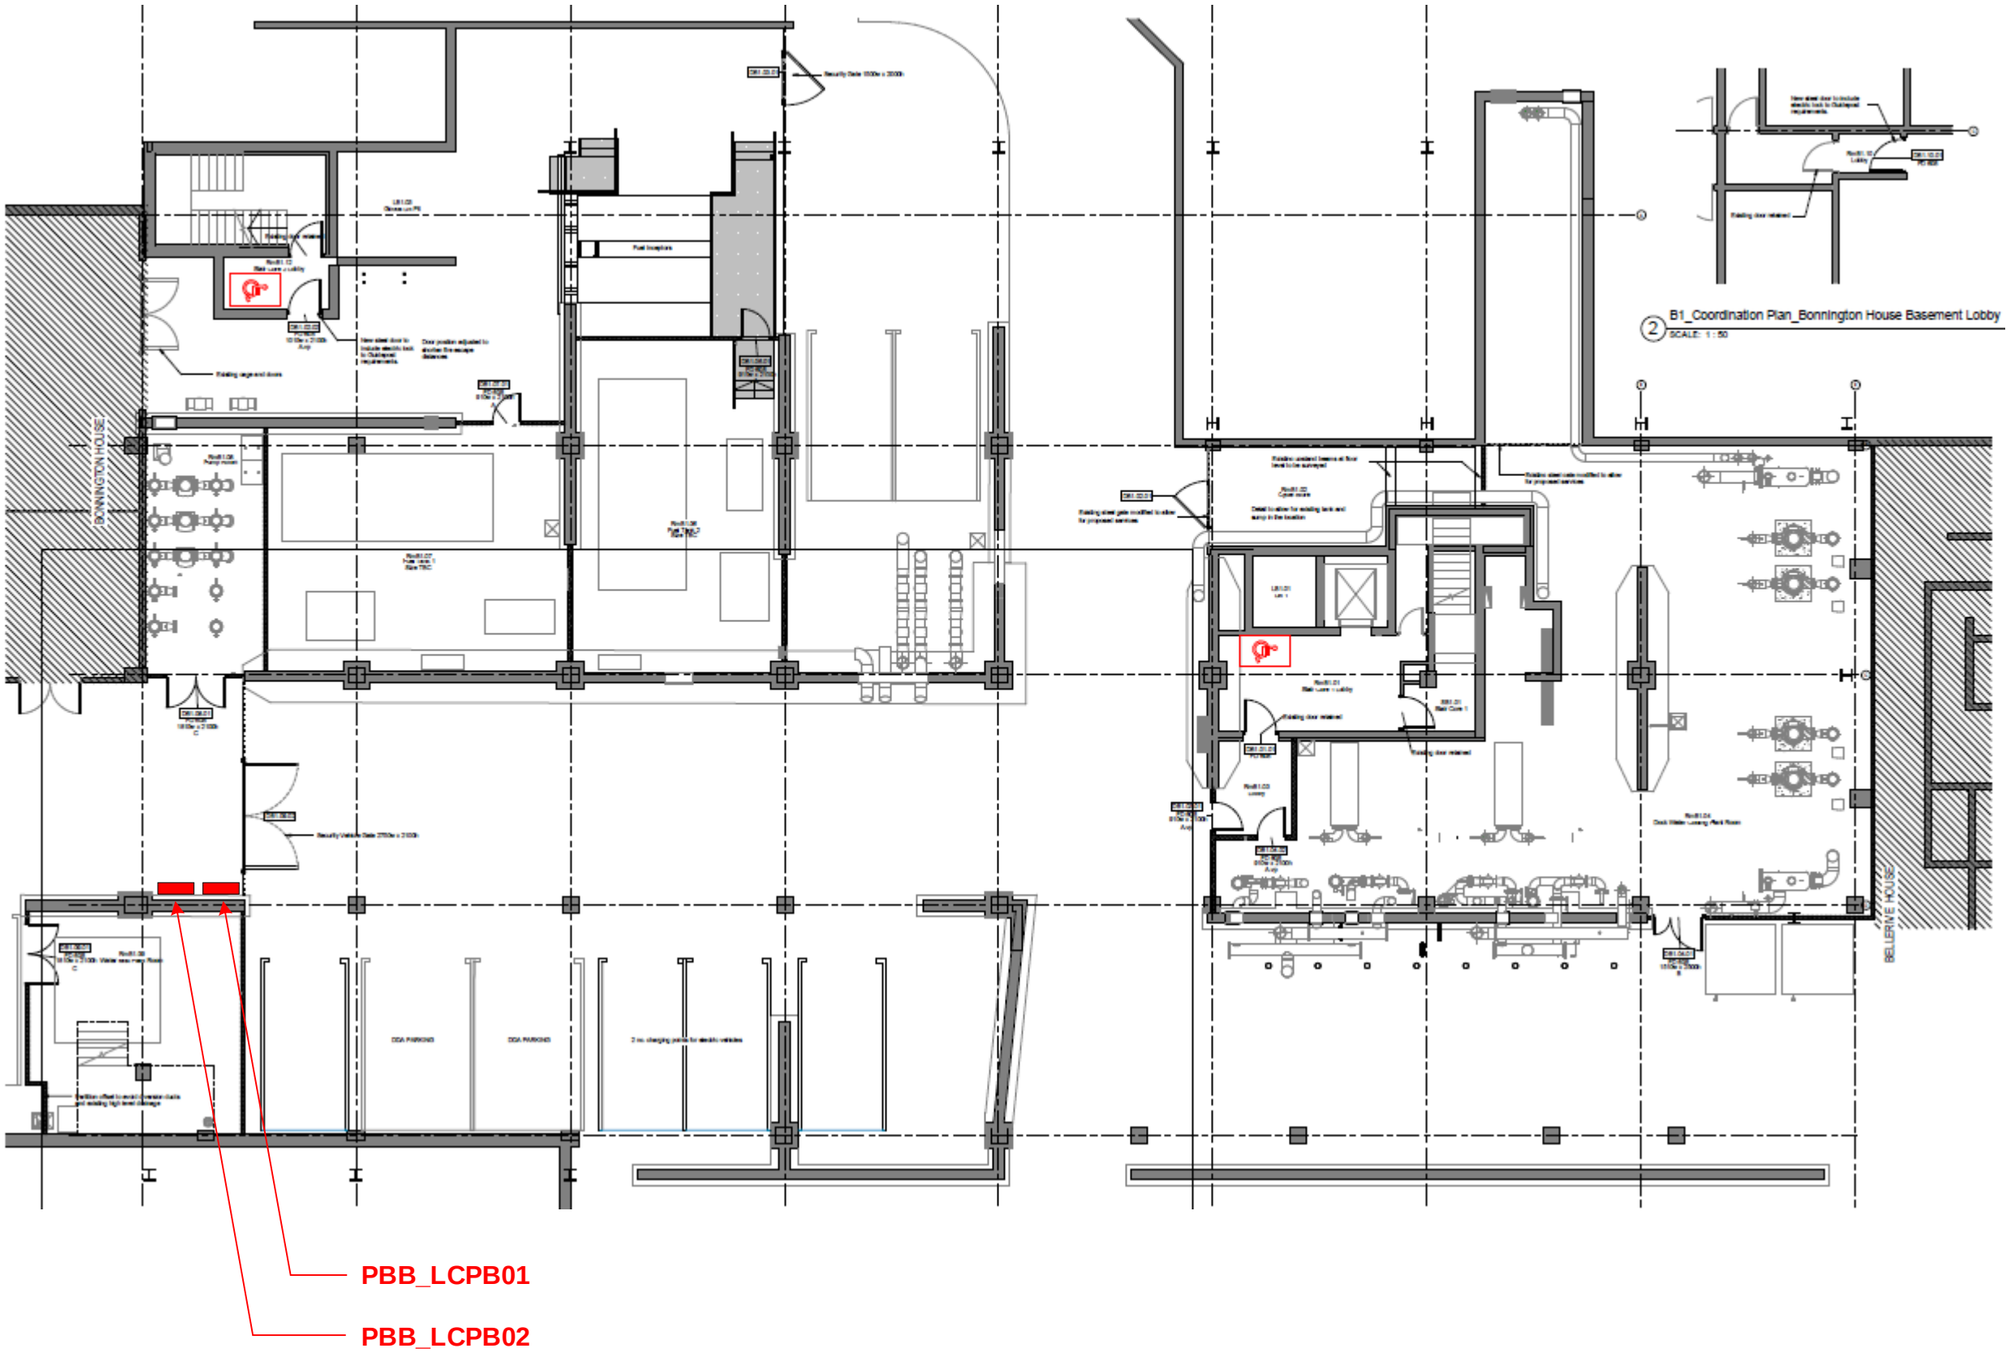

2 B1_Coordination Plan_Bonnington House Basement Lobby
SCALE: 1 : 50

Project	Title	Project Number	Client
LHR19	Basement BMS Equipment Locations	T1.00869	Digital Realty
		Sheet Name: Level B1	Contractor: Gratte Brothers

Rev	Description	Date	Drawn	Checked
P1	First Issue	06/06/19	NL	NL
C1	Panel Locations Amended	11/07/19	NL	NL
AB1	As Installed	05/11/19	NL	NL
.	.	.	.	.
.	.	.	.	.
.	.	.	.	.
.	.	.	.	.

Notes
1 - All IT infrastructure by others
2 - All power supplies by others
3 - CAT 5e cable
4 - RS485 Belden 9182 or equivalent

Schneider Electric

Page Size	Design Stage	
A3	Concept Design	
	Developed Design	
	Technical Design	✓
	Information Only	

Sheet	Drawing Number	Rev
1 of 1	GB7102-SCN-E-DR-B1-0001	AB1

These drawings and designs are the property of Schneider Electric. Their use or reproduction without prior consent of the company is strictly forbidden.